



EXISTING FLOOR PLAN 3  
 SCALE: 1/4" = 1'-0" A0.0

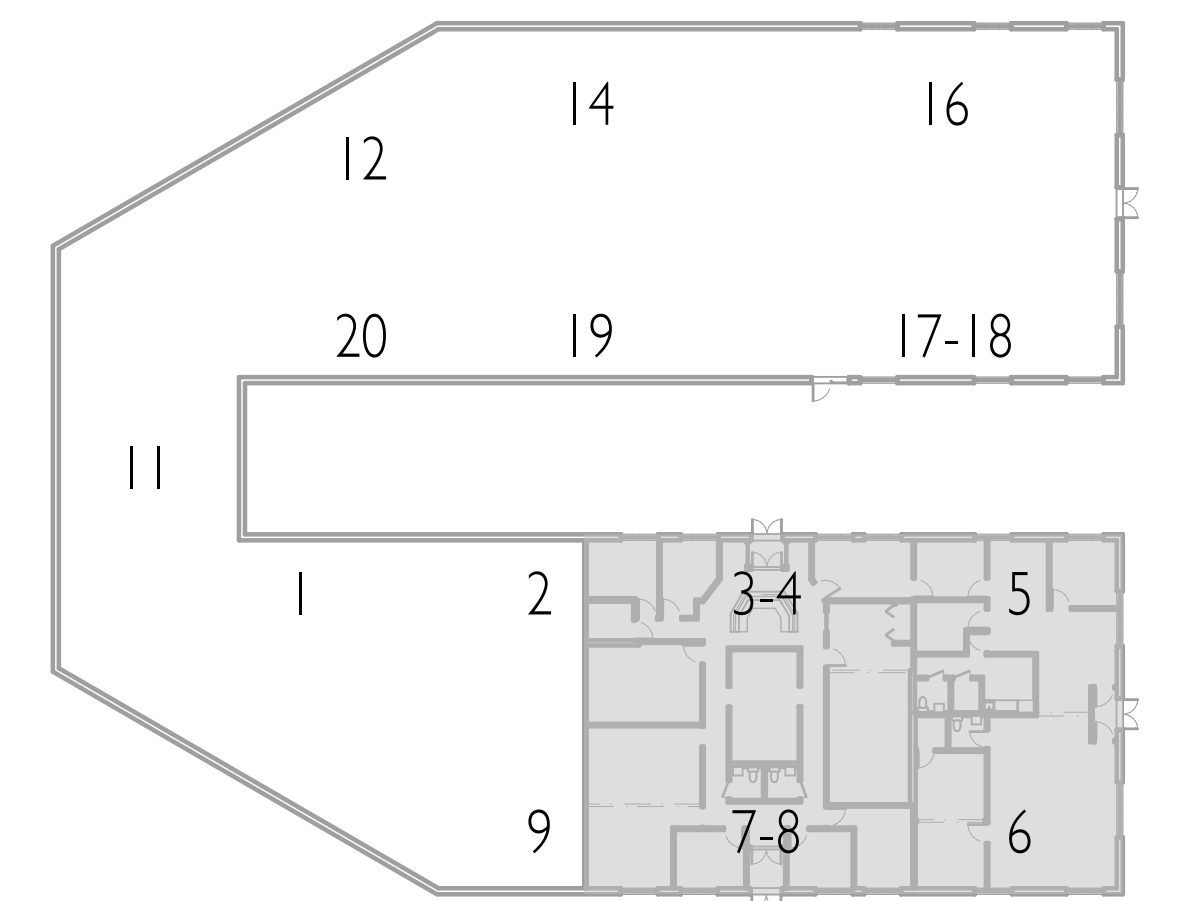

TENANT SPACE KEY 2  
 NOT TO SCALE A0.0

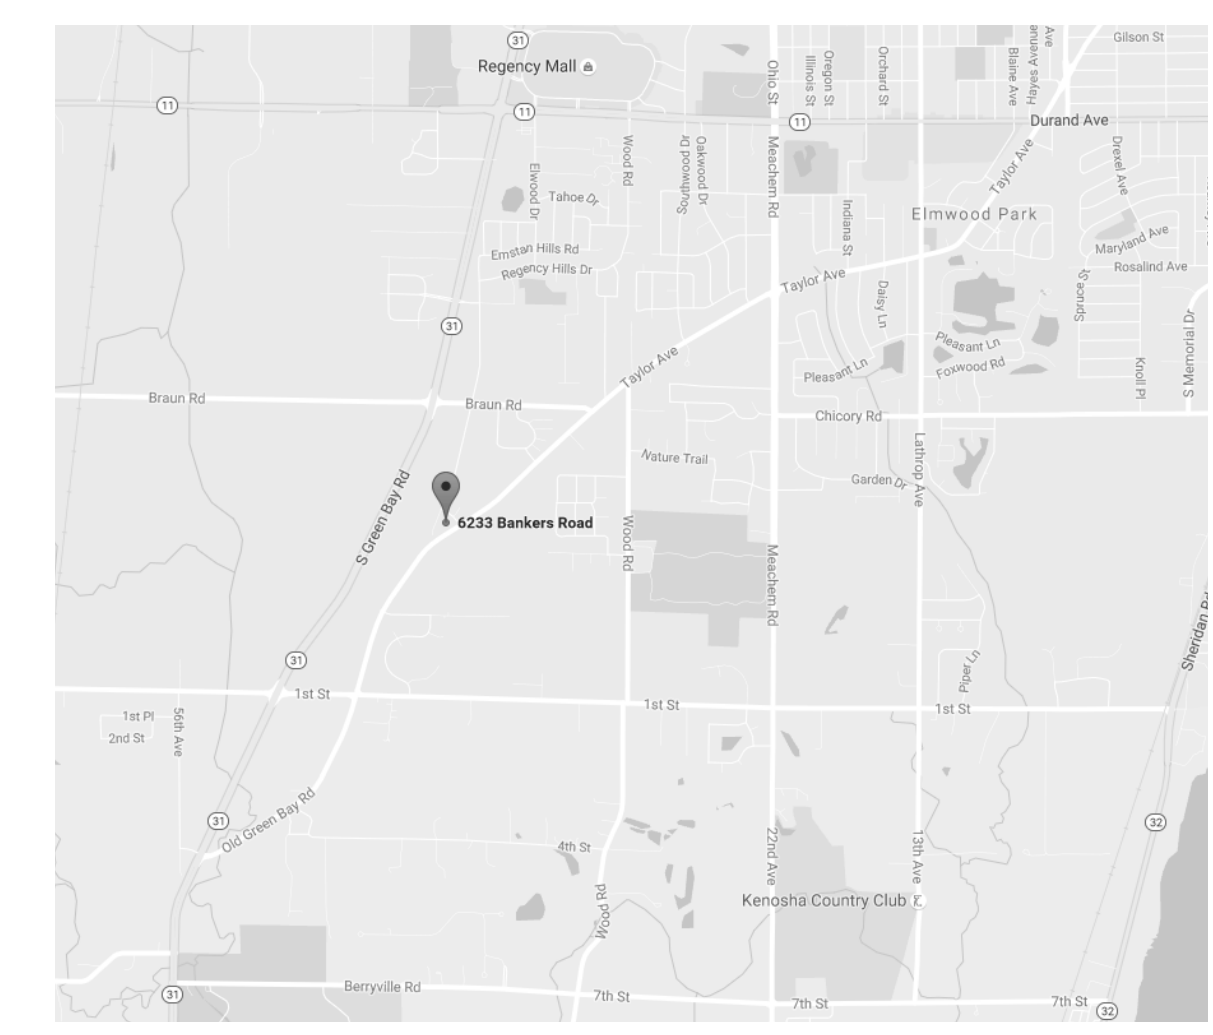


LOCATION MAP 1  
 NOT TO SCALE A0.0

**TAYLOR CROSSING**  
 SUITES 3-8  
 PROJECT #10431  
 6233 BANKERS ROAD  
 MOUNT PLEASANT, WISCONSIN 53403

02.20.17	AS-BUILT TENANT SPACE
----------	-----------------------

COPYRIGHT 2017 GENESIS ARCHITECTURE, LLC  
 UNAUTHORIZED REPRODUCTION OF THESE  
 PLANS IS PROHIBITED BY LAW

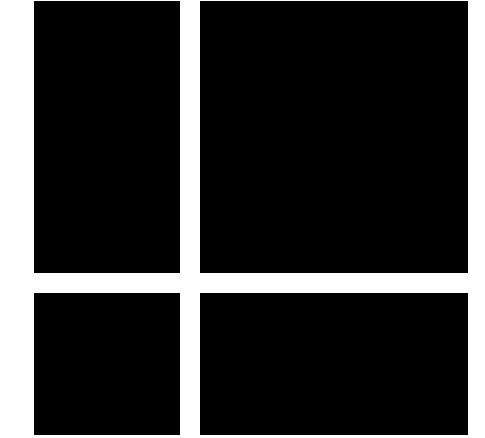

**GENESIS**  
 Architecture, LLC  
 6929 MARINER DR., SUITE A  
 RACINE, WISCONSIN 53406  
 TEL . 262-752-1894  
 FAX . 262-752-1895  
 www.genesisarchitecture.com  
 office@genesisarchitecture.com

2/20/17

**A0.0**

COVER SHEET

